




PLAN 02 - 1:400

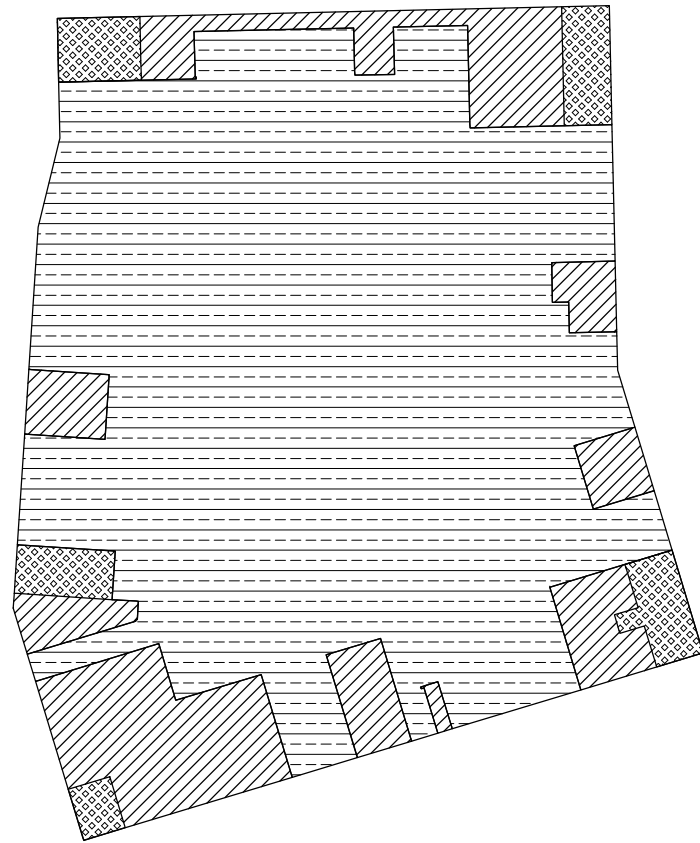


PLAN 01 (GARAGE) - 1:400

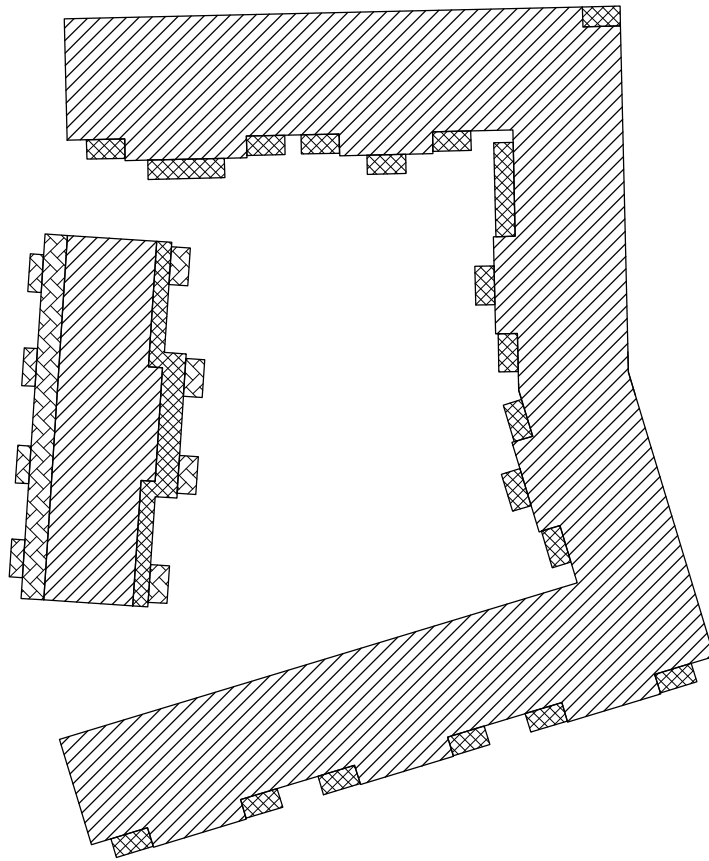


PLAN 06 - 1:400

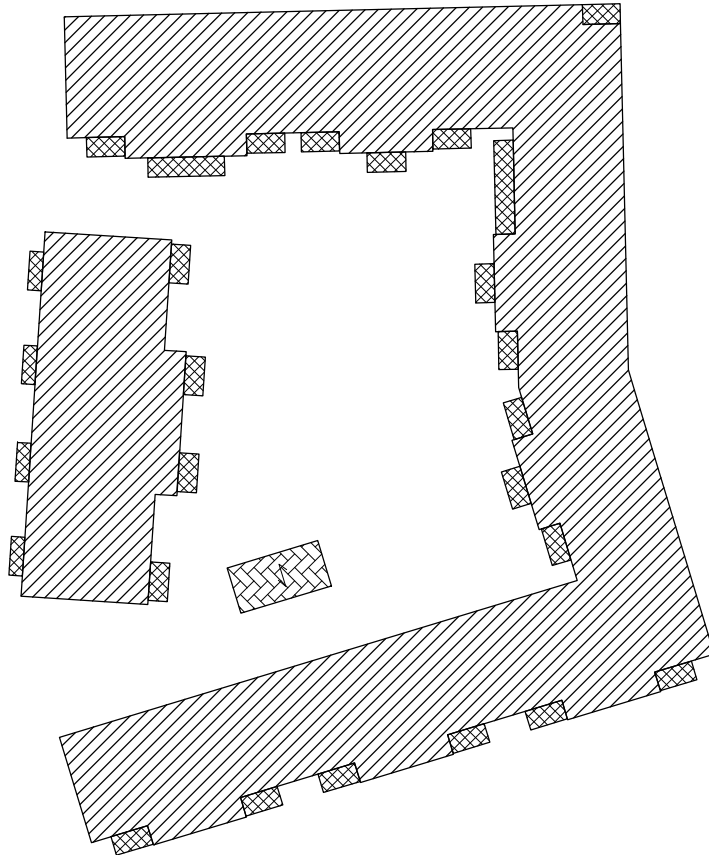

PLAN 03-05 - 1:400

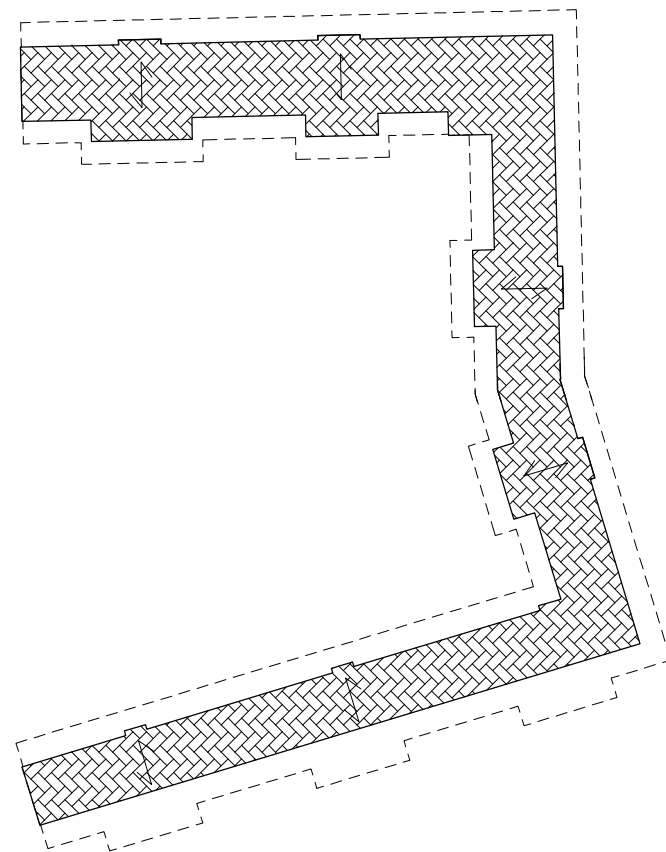

PLAN 08 (ROOF) - 1:400

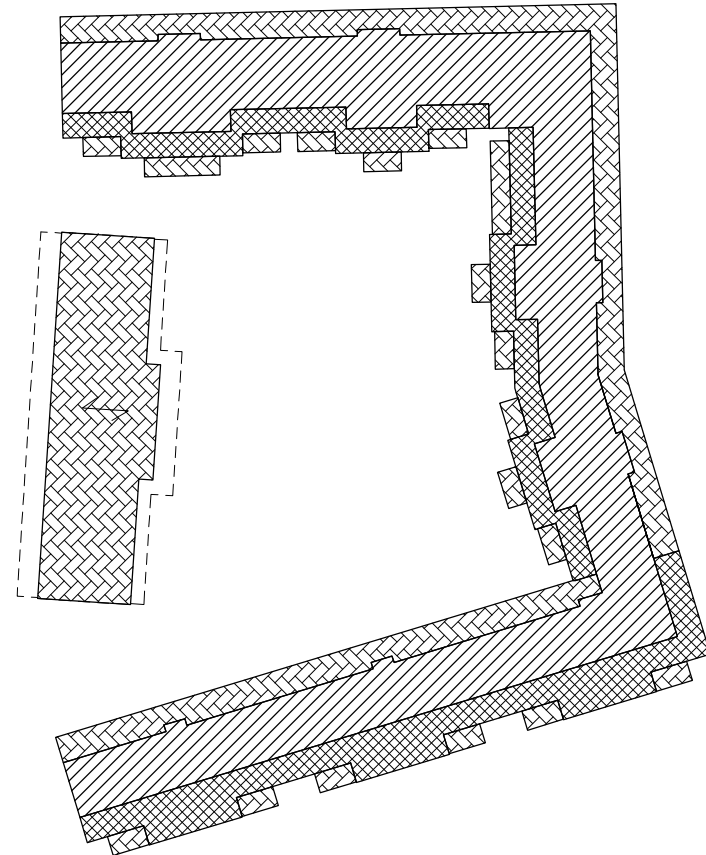
 







PLAN 07 - 1:400

FÖRESKRIFTER

ALLMÄNNA FÖRESKRIFTER
SE RITNING K-01-0-0000 OCH K-01-0001.

 FÖRKLARINGAR

	CATEGORY	DESCRIPTION	q_k (kN/m ²)	q_k (kN)	Y0 Y1 Y2
	A	SLABS/STAIRS	2,0	2,0	0,7 0,5 0,3
	A	BALCONIES	3,5	2,0	0,7 0,5 0,3
	A	SLABS	2,5	2,0	0,7 0,5 0,3
	A	SLABS ("INSTALLATION")	1,0	-	1,0 1,0 1,0
	D1	SLABS/STAIRS	4,0	4,0	0,7 0,7 0,6
	C5	SLABS ("GÅRDSBJL.")	5,0	4,5	0,7 0,7 0,6
	F	SLABS ("GARAGE")	2,5	20	0,7 0,7 0,6
	F	WALLS/COLUMNS x)	-	5	0 0 0
	SNOW	SNOW LOAD x x)	2,0	-	0,7 0,4 0,2
N/A	WIND	WIND LOAD x x x)	-	-	0,3 0,2 0

- x) HORIZONTAL LOAD ACCORDING TO EKS 8
("6.3.2.2(1) i tabell 6.8, 11 §", page 19).
- xx) PRESSURE AND FORCE COEFFICIENTS ACCORDING
TO SS-EN 1991-1-3.
"SNÖFICKOR" TO BE CONSIDERED.
- xxx) $v_b=24$ m/s, TERRAIN CATEGORY III
PRESSURE AND FORCE COEFFICIENTS ACCORDING
TO SS-EN 1991-1-4


TEMPORARY AND ACCIDENTAL LOADS

TEMPORARY LOADS: ACCORDING TO SS-EN
1991-1-6:2005
(ACTIONS DURING EXECUTION)

ACCIDENTAL LOADS: ACCORDING TO SS-EN
1991-1-7:2006
(ACCIDENTAL ACTIONS)

BET	ANT	ÄNDRINGEN AVSER	SIGN	DATUM
-----	-----	-----------------	------	-------

RELATIONSHANDLING

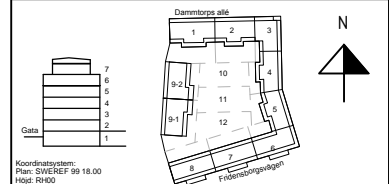

Kv. Liljekonvaljen
JÄRVASTADEN, SOLNA

SKANSKA

A	Skanska Teknik	Tel. 010-448 00 00
K	Bjerkling	Tel. 010-211 80 00
V	Resista AB	Tel. 08-594 970 70
V	Energogavals	+37467112350
W	ÅF Infrastruktur AB	Tel. 010 505 00 00
L	Landskapslaget AB	Tel. 08-442 48 20

UPPDRAG NR 13U22880	RITAD AV MJN	UPPDRAGSANSVARIG MJN
DATUM 2016-02-15	GODKÄND AV MJN	

NYBYGGNAD FLERBOSTADSHUS

LASTPLANER
NYTTIGA LASTER, LIVE LOADS

SKALA A1: A3:	NUMMER K-01-0-0002	BET
---------------------	-----------------------	-----