


RELATIONSHANDLING

Dammkörper alle		
1	2	3

N

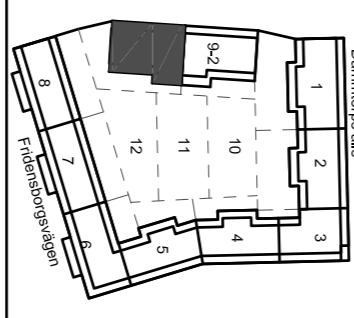

2A

A

Tel. 010-448 00 00
Tel. 010-211 80 00
Tel. 08-594 970 70
Tel. +37167112350
Tel. 010 505 00 00
Tel. 08-442 48 20

UPPDÄGSKANSVÄRIG MN	
Nordlund	

274

1 BEI

PLO: 2016-01-31 16:05 S:\PROJEKT\2013\13020\E\MODELL\E-63-P-0500.DWG MATS