
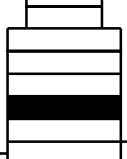



The floor plan illustrates a multi-unit residential building layout. Key features include:

- Room Labels:** SOV (sofa), KÖK (kitchen), BAD (bathroom), VARDAGSRUM (living room), KLK (kitchenette), HSS (hallway), TRAPPHUS (staircase), PASSAGE, BALKONG (balcony), and various storage areas (G, L, ST, K, V, F, S, SG, K/F, E, J, M, D).
- Technical Specifications:** Each unit is identified by a code (e.g., CK 22K 410, CK 21K 310, CK 11K 310) and associated dimensions and flow rates (e.g., 410 W/0.0066 l/s/0.06, 320 W/0.0052 l/s/0.05, 340 W/0.0055 l/s/0.06).
- Grid System:** The plan is organized by a grid with vertical lines labeled 410, 320, 340, 90, 130, 320, 190, 350 and horizontal lines labeled B01, B03, and B04.
- Unit Details:**
 - Unit 410:** CK 22K 410, 410 W/0.0066 l/s/0.06. Rooms include SOV 2 (7.0 m²), KÖK K1T (20.5 m²), BAD (8.6 m²), and VARDAGSRUM (23.5 m²).
 - Unit 320:** CK 21K 310, 320 W/0.0052 l/s/0.05. Rooms include SOV 1 (12.5 m²), KÖK K1S (24.0 m²), and VARDAGSRUM (17.5 m²).
 - Unit 340:** CK 21K 314, 340 W/0.0055 l/s/0.06. Rooms include SOV 1 (11.0 m²), KÖK K1S (24.0 m²), and VARDAGSRUM (17.5 m²).
 - Unit 90:** CK 11K 304, 90 W/0.0015 l/s/0.02. Rooms include SOV 1 (12.5 m²), KÖK K1S (24.0 m²), and VARDAGSRUM (17.5 m²).
 - Unit 130:** CK 21K 310, 130 W/0.0021 l/s/0.02. Rooms include SOV 1 (12.5 m²), KÖK K1S (24.0 m²), and VARDAGSRUM (17.5 m²).
 - Unit 320:** CK 21K 310, 320 W/0.0052 l/s/0.06. Rooms include SOV 1 (12.5 m²), KÖK K1S (24.0 m²), and VARDAGSRUM (17.5 m²).
 - Unit 190:** CK 21K 310, 190 W/0.0031 l/s/0.04. Rooms include SOV 1 (12.5 m²), KÖK K1S (24.0 m²), and VARDAGSRUM (17.5 m²).
 - Unit 350:** CK 21K 310, 350 W/0.0031 l/s/0.04. Rooms include SOV 1 (12.5 m²), KÖK K1S (24.0 m²), and VARDAGSRUM (17.5 m²).

The plan is signed by DEL 1 and DEL 2.

BET	ANT	ÄNDRINGEN AVSER	SIGN	DATUM
<h1 style="margin: 0;">RELATIONSHANDLING</h1>				
<div style="display: flex; justify-content: space-around; align-items: center;"> <div style="text-align: center;">  <p style="margin: 5px;">Gata</p> </div> <div style="text-align: center;">  </div> <div style="text-align: center;"> <p style="margin: 0;">N</p>  </div> </div>				
Koordinatstycken: Plan: SWEREF 99 18.00 Höjd: RH200				
<h2 style="margin: 0;">Kv. Liljekonvaljen</h2> <p style="margin: 0;">JÄRVASTADEN, SOLNA</p>				
<h1 style="margin: 0;">SKANSKA</h1>				
A Skanska Teknik			Tel 010-448 00 00	
K Bjerkning			Tel 010-211 80 00	
E Resistå AB			Tel 08-594 970 70	
V Energoavals			Tel -37167112350	
W ÅF Infrastruktur AB			Tel 010 505 00 00	
L Landskapslager AB			Tel 08-442 48 20	
UPPGÄVS NR 587931		RTAD AV FRIEDRICH		UPPGÄSSANSVARG OLH
DATUM 2016-02-15		GODKÄND AV S. J. J.		
<div style="display: flex; justify-content: space-between;"> <div> <p style="margin: 0;">NYBYGGNAD FLERBOSTADSHUS</p> <p style="margin: 0;">RÖRSTYSTEM</p> <p style="margin: 0;">PLAN 3</p> <p style="margin: 0;">TRAPPHUS 1, FG -26.90</p> </div> <div style="text-align: right;"> <p style="margin: 0;">SKALA A1:150 A3:100</p> </div> </div>				
<h2 style="margin: 0;">V-50-1-1301</h2>				
Skapad av: V-50-1-1301				BET

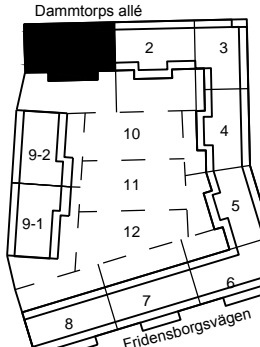