

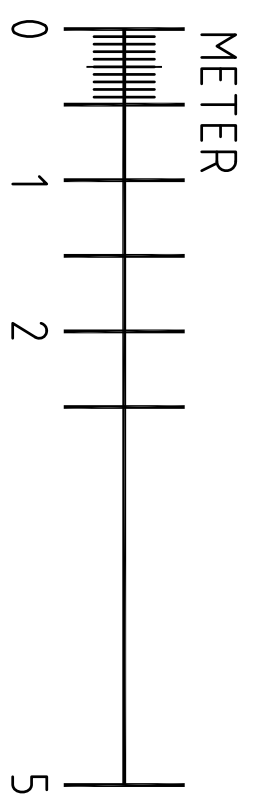


FÖRKLARINGAR

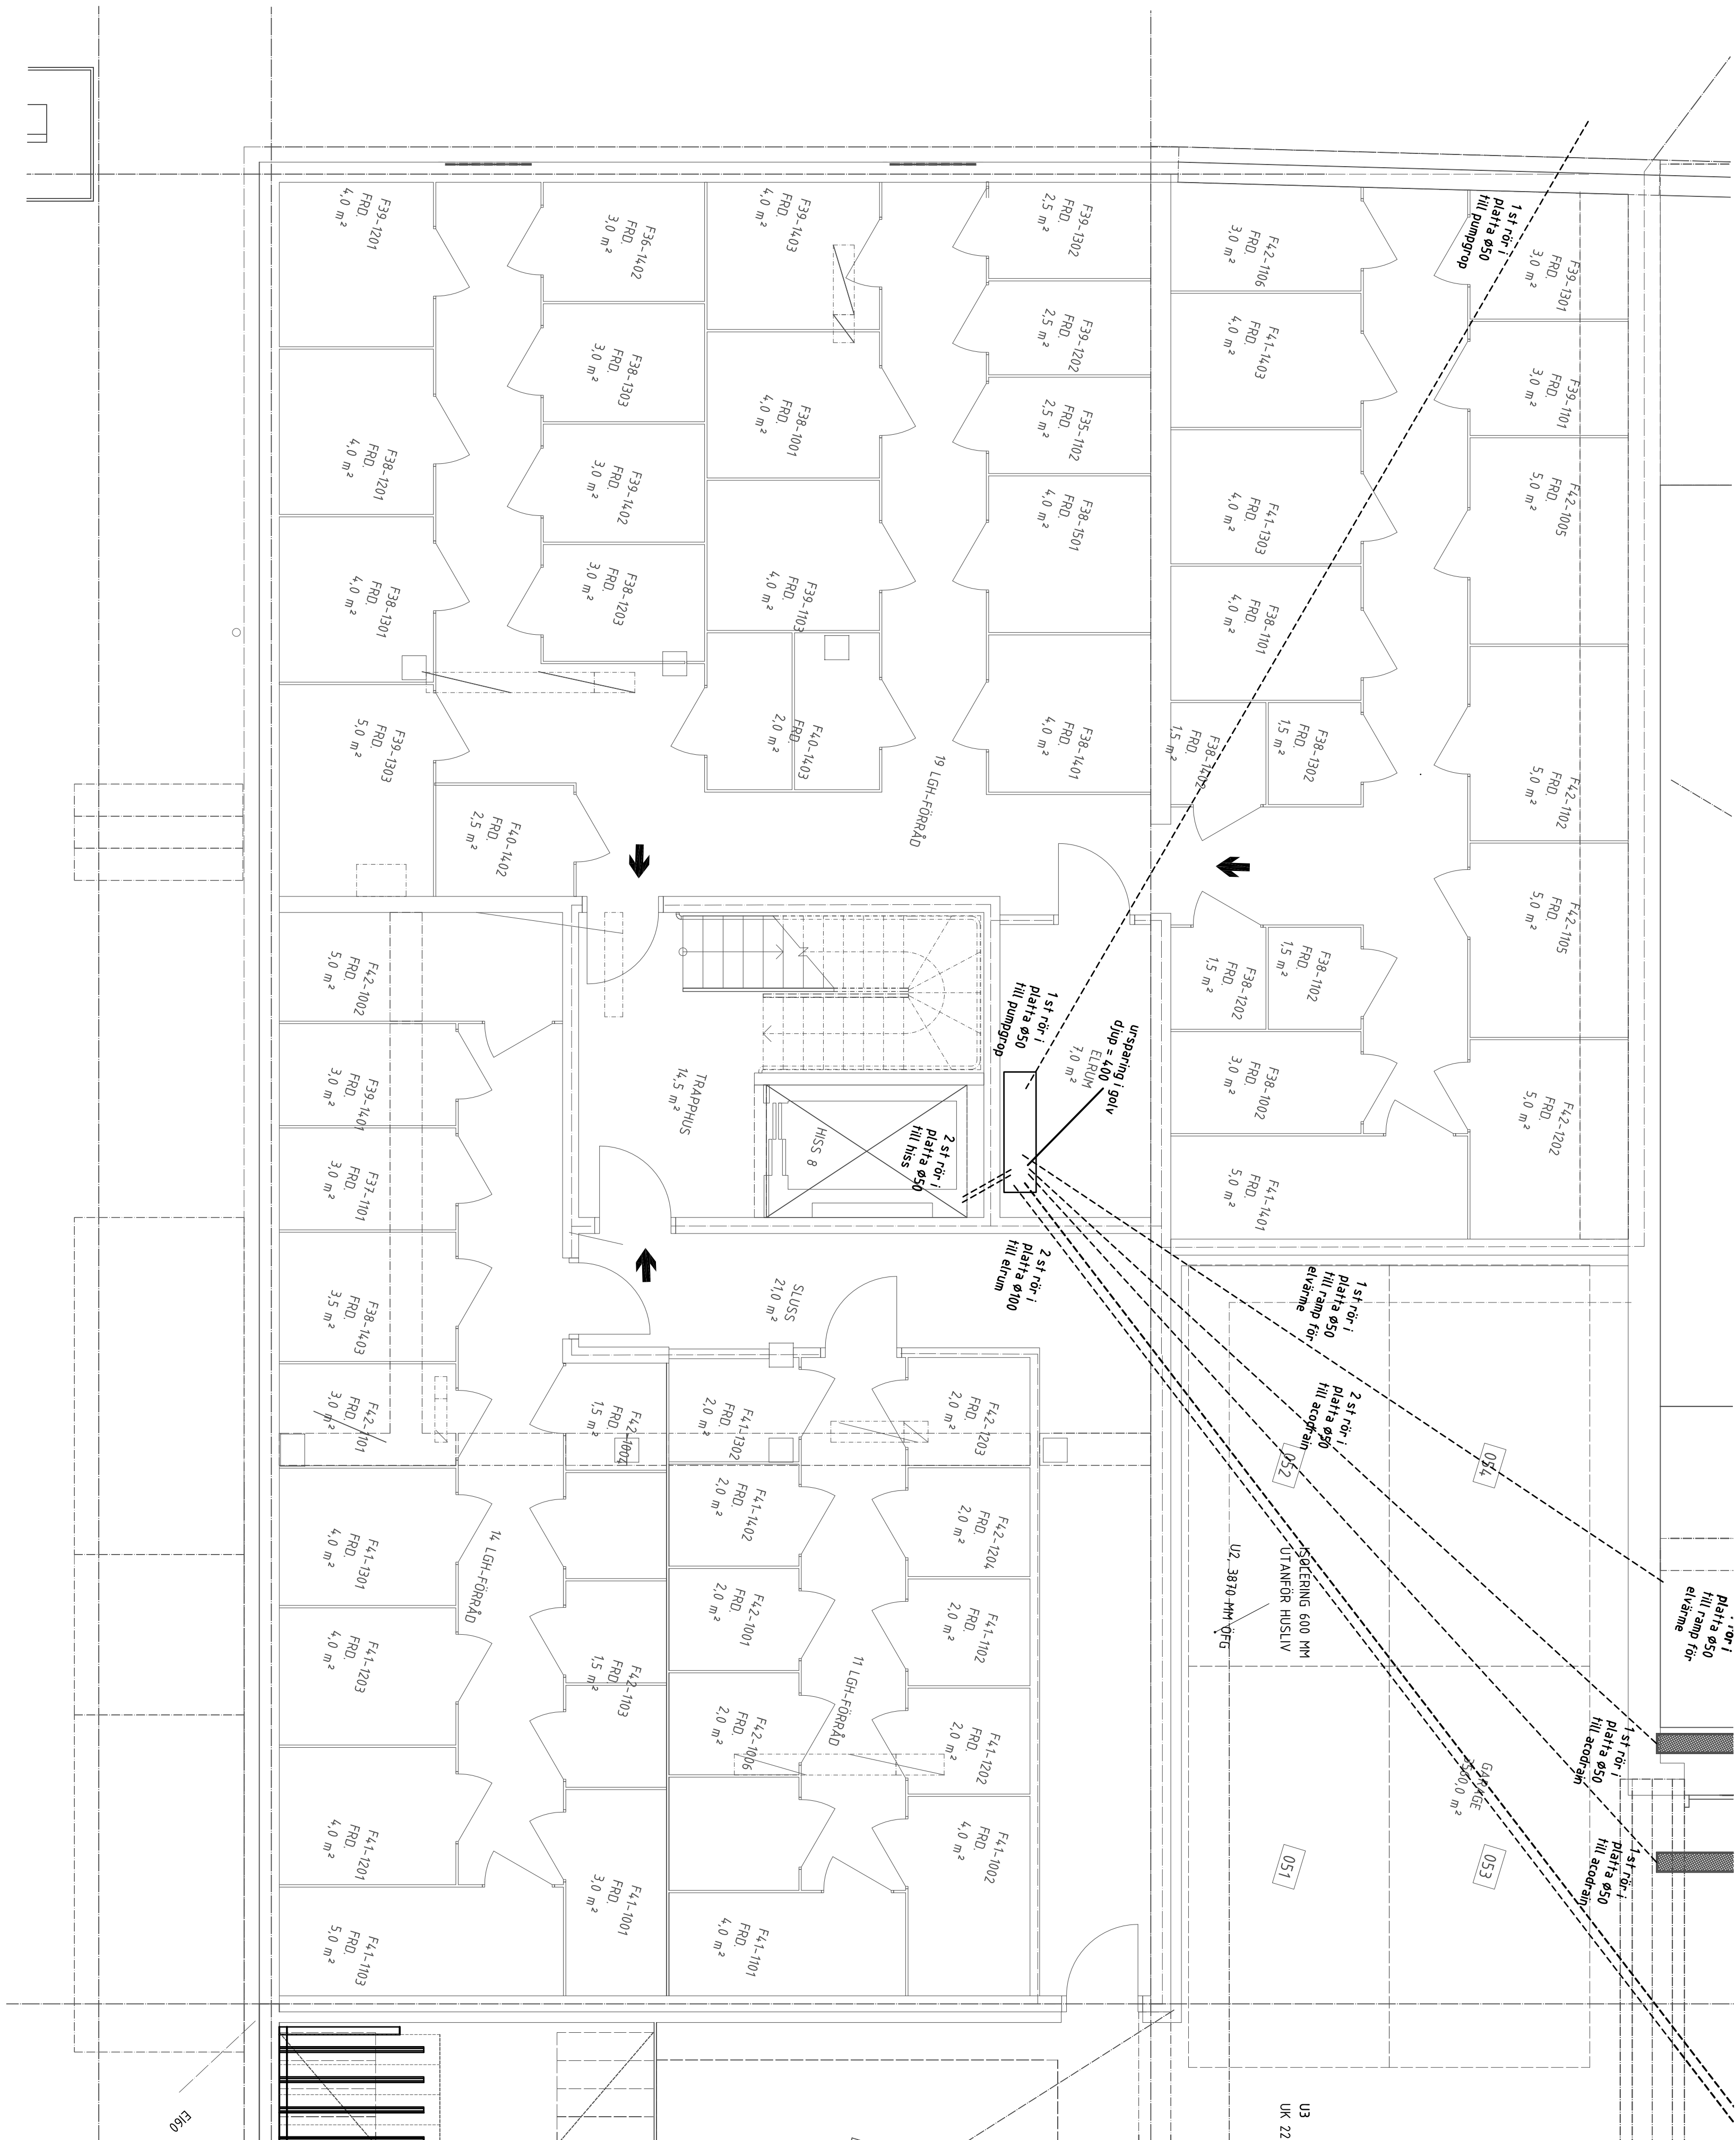

	RELATIONSHANDLING	MN	2016.02.15
BET	ÄNDRINGEN AVSER	SIGN	DATUM

RELATIONSHANDLING

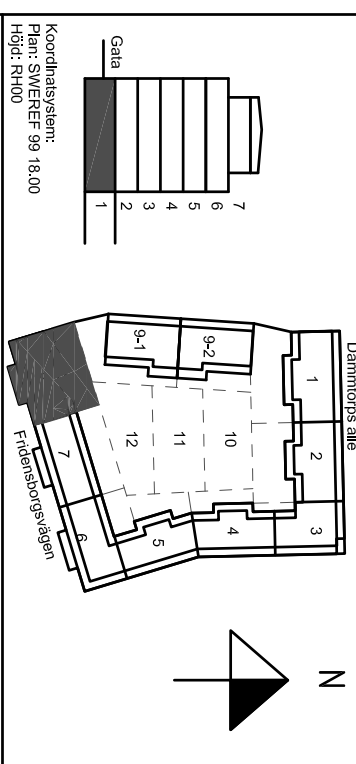

Kv. Liljekonvaljer
JÄRVASTADEN, SOLNA

SKANSKA

A	Shamsia Teknik	Tel. 010-448 00 00
K	Beijing	Tel. 010-211 80 00
E	Resita AB	Tel. 08-596 970 70
V	Emegonavis	Tel. +3767112350
W	AF Infrastruktur AB	Tel. 010 505 00 00
L	Landspasslaget AB	Tel. 08-442 48 20

DATUM	GÖRÅRD AV	
2013.11.22	Mats Nordlund	

HUS 2, PLAN 11 GOLV (KV), TRH 8

